

Date: Thursday, 6/15/2006 1:48:12 PM
 User: Kim Johnston

Process Sheet

Customer	: CU-DAR001 Dart Helicopters Services		Drawing Name	: BASKET BASE ASSEMBLY (350)		
Job Number	: 27577A					
Estimate Number	: 10189					
P.O. Number	: N/A			Part Number	: D2221	
This Issue	: 6/15/2006 S.O. No. : N/A			Drawing Number	: D2221/D2235	
Prsht Rev.	: NC			Project Number	: N/A	
First Issue	: N/A			Drawing Revision	: F/B1	
Previous Run	: 27576A			Material	: N/A	
Written By	: <i>See Comments Below</i>			Due Date	: 7/10/2006	
Checked & Approved By	: <i>KK 06.06.15</i>			Qty:	1 Um: Each	
Comment	: Est Rev:J 05.09.02 Added D3442-1KJ/JLM					

Additional Product

Job Number:



Seq. #:	Machine Or Operation:	Description :	
1.0	D31661	Basket Hoop	
		Comment: Qty.: 4.0000 Each(s)/Unit Total : 4.0000 Each(s)	
		Pick:	
		Qty Part Number Description Batch	
		4 D3166-1 RIB <i>B27326</i>	<i>CPL 06-06-26</i>
2.0	D22323	Basket Hinge	
		Comment: Qty.: 2.0000 Each(s)/Unit Total : 2.0000 Each(s)	
		Pick:	
		Qty Part Number Description Batch	
		2 D2232-3 Hinge bracket <i>B24527</i>	<i>CPL 06-06-26</i>
3.0	D2325	Support Gusset (350 Bask)	
		Comment: Qty.: 4.0000 Each(s)/Unit Total : 4.0000 Each(s)	
		Pick:	
		Qty Part Number Description Batch	
		4 D2325 Support Gusset <i>B26741</i>	<i>CPL 06-06-26</i>
4.0	D23273	Spacer Bushing	
		Comment: Qty.: 2.0000 Each(s)/Unit Total : 2.0000 Each(s)	
		Pick:	
		Qty Part Number Description Batch	
		2 D2327-3 Bushing <i>B27051</i>	<i>CPL 06-06-26</i>

W/O:		WORK ORDER CHANGES					
DATE	STEP	PROCEDURE CHANGE	By	Date	Qty	Approval Mfg / Design Mgr	Approval QC Inspector

NCR:		WORK ORDER NON-CONFORMANCE (NCR)						
DATE	STEP	Description of NC Section A	Corrective Action Section B			Verification Section C	Approval Design Mgr	Approval QC Inspector
			Initial Design Mgr	Action Description Design Mgr	Sign & Date			

Part No: _____ PAR #: _____ Fault Category: _____ NCR: Yes No DQA: _____ Date: _____

NOTE: Date & initial all entries QA: N/C Closed: _____ Date: _____

Date: Thursday, 6/15/2006 1:48:13 PM
User: Kim Johnston

Process Sheet

Customer: CU-DAR001 Dart Helicopters Services

Drawing Name: BASKET BASE ASSEMBLY (350)

Job Number: 27577A

Part Number: D2221

Job Number:



Seq. #: Machine Or Operation:

Description :

5.0 D2581 Mounting Bracket



Comment: Qty.: 2.0000 Each(s)/Unit Total : 2.0000 Each(s)

Pick:

Qty Part Number Description Batch
2 D2581 Mounting Bracket B21587

CPL 06.06.26

6.0 D34421 Shim



Comment: Qty.: 2.0000 Each(s)/Unit Total : 2.0000 Each(s)

Pick:

Qty Part Number Description Batch
2 D3442-1 Shim B26739

CPL 06.06.26

7.0 M304EX07516F Expanded Metal Flat Stai



Comment: Qty.: 39.6900 sf(s)/Unit Total : 39.6900 sf(s)

Pick:

Qty Part Number Description Batch
36 sf M304EX0.75-16F Expanded Metal M101358

CPL 06.06.28

8.0 M304TS0750W065 304 SQ Tube.75x.75x.065W



Comment: Qty.: 29.4000 f(s)/Unit Total : 29.4000 f(s)

Pick:

28' 3/4" x 3/4" x 0.063 wall 304/316 SStubing
Batch M101309 → 336.01

CPL

06.06.28

9.0 LARGE FAB 1 LARGE FABRICATION RESOURCE 1



Comment: LARGE FABRICATION RESOURCE 1

1-Cut D2235-1 Rib from D3166-1 Rib As Per Dwg D2235

CPL 06.07.10

2-Drill hole in D2221-3 as per Dwg D2221

3-Deburr

4-Remove all markings on material before welding

5-Weld as per Dwg D2221 using Welding Table and corner JigDeburr as required

W/O:		WORK ORDER CHANGES					
DATE	STEP	PROCEDURE CHANGE	By	Date	Qty	Approval Mfg / Design Mgr	Approval QC Inspector

NCR:		WORK ORDER NON-CONFORMANCE (NCR)						
DATE	STEP	Description of NC Section A	Corrective Action Section B			Verification Section C	Approval Design Mgr	Approval QC Inspector
			Initial Design Mgr	Action Description Design Mgr	Sign & Date			

Part No: _____ PAR #: _____ Fault Category: _____ NCR: Yes No DQA:  Date: 06/07/14

NOTE: Date & initial all entries

QA: N/C Closed: _____ Date: _____

Date: Thursday, 6/15/2006 1:48:13 PM
User: Kim Johnston

Process Sheet

Customer: CU-DAR001 Dart Helicopters Services

Drawing Name: BASKET BASE ASSEMBLY (350)

Job Number: 27577A

Part Number: D2221

Job Number:



Seq. #: Machine Or Operation:

Description :

10.0 QC9/6 DDIMENSIONAL & WELDING INSPECTION



Comment: DDIMENSIONAL & WELDING INSPECTION

PD 06-07-10 ①

11.0 POWDER COATING POWDER COATING



Comment: POWDER COATING

Powder Coat White Gloss (Ref: 4.3.5.1) as per QSI 005 4.3

SC 06/07/11 ①

12.0 QC3 INSPECT POWDER COAT/CHEMICAL CONVERSION



Jog-07-12 ①

Comment: INSPECT POWDER COAT/CHEMICAL CONVERSION

13.0 HAND FINISHING1 HAND FINISHING RESOURCE #1



Comment: HAND FINISHING RESOURCE #1

Seal support gusset seam with white sikaflex-291 Batch: M161193

Expiry date: 11/06

SD 06-07-12 ①

14.0 DC DOCUMENT CONTROL



Comment: DOCUMENT CONTROL

Inspection Level 21

11 06-07-14

Job Completion



U 06-07-14

W/O:		WORK ORDER CHANGES					
DATE	STEP	PROCEDURE CHANGE	By	Date	Qty	Approval Mfg / Design Mgr	Approval QC Inspector

NCR:		WORK ORDER NON-CONFORMANCE (NCR)						
DATE	STEP	Description of NC Section A	Corrective Action Section B			Verification Section C	Approval Design Mgr	Approval QC Inspector
			Initial Design Mgr	Action Description Design Mgr	Sign & Date			

Part No: _____ PAR #: _____ Fault Category: _____ NCR: Yes No DQA: _____ Date: _____

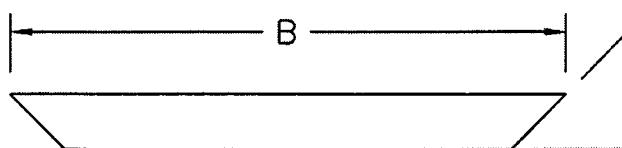
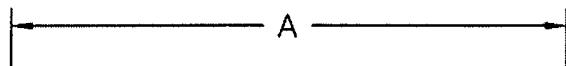
NOTE: Date & initial all entries QA: N/C Closed: _____ Date: _____

DART

DESIGN BW	DRAWN BY PH	DART AEROSPACE LTD HAWKESBURY, ONTARIO, CANADA	
CHECKED <i>[initials]</i>	APPROVED <i>[initials]</i>	DRAWING NO. D2221	REV. F SHEET 1 OF 3
DATE 05.06.07		TITLE BASKET BASE ASSEMBLY (350)	SCALE NTS
C	95.11.21	SEPARATE BASKET AND LID	
D	96.06.21	CHANGE LATCH	
E	01.04.19	CHANGE HINGE	
F	05.06.07	ADD SHIM UNDER HINGES, ADD HOLES FOR SPLIT LID BASKETS	

RELEASED05.08.19 *[initials]*PARTS LIST FOR D2221 BASKET BASE ASSEMBLY

PART NO	QUANTITY	LENGTH A	LENGTH B	DESCRIPTION
D2221-1	2	—	96.00	RIB
D2221-3	2	—	25.50	RIB
D2221-5	2	18.88	—	RIB
D2221-7	1	55.25	—	RIB
D2232-3	2	N/A	N/A	HINGE PLATE
D2235-1	4	N/A	N/A	RIB
D2325	4	N/A	N/A	SUPPORT GUSSET
D2327-3	2	N/A	N/A	BUSHING
D2581	2	N/A	N/A	MTG BRKT
D3442-1	2	N/A	N/A	SHIM



SHOP COPY
RETURN TO
ENGINEERING
UNCONTROLLED COPY
SUBJECT TO AMENDMENT

WITHOUT NOTICE
WORK ORDER
NO. 22577A

D2221-1/-3/-5/-7

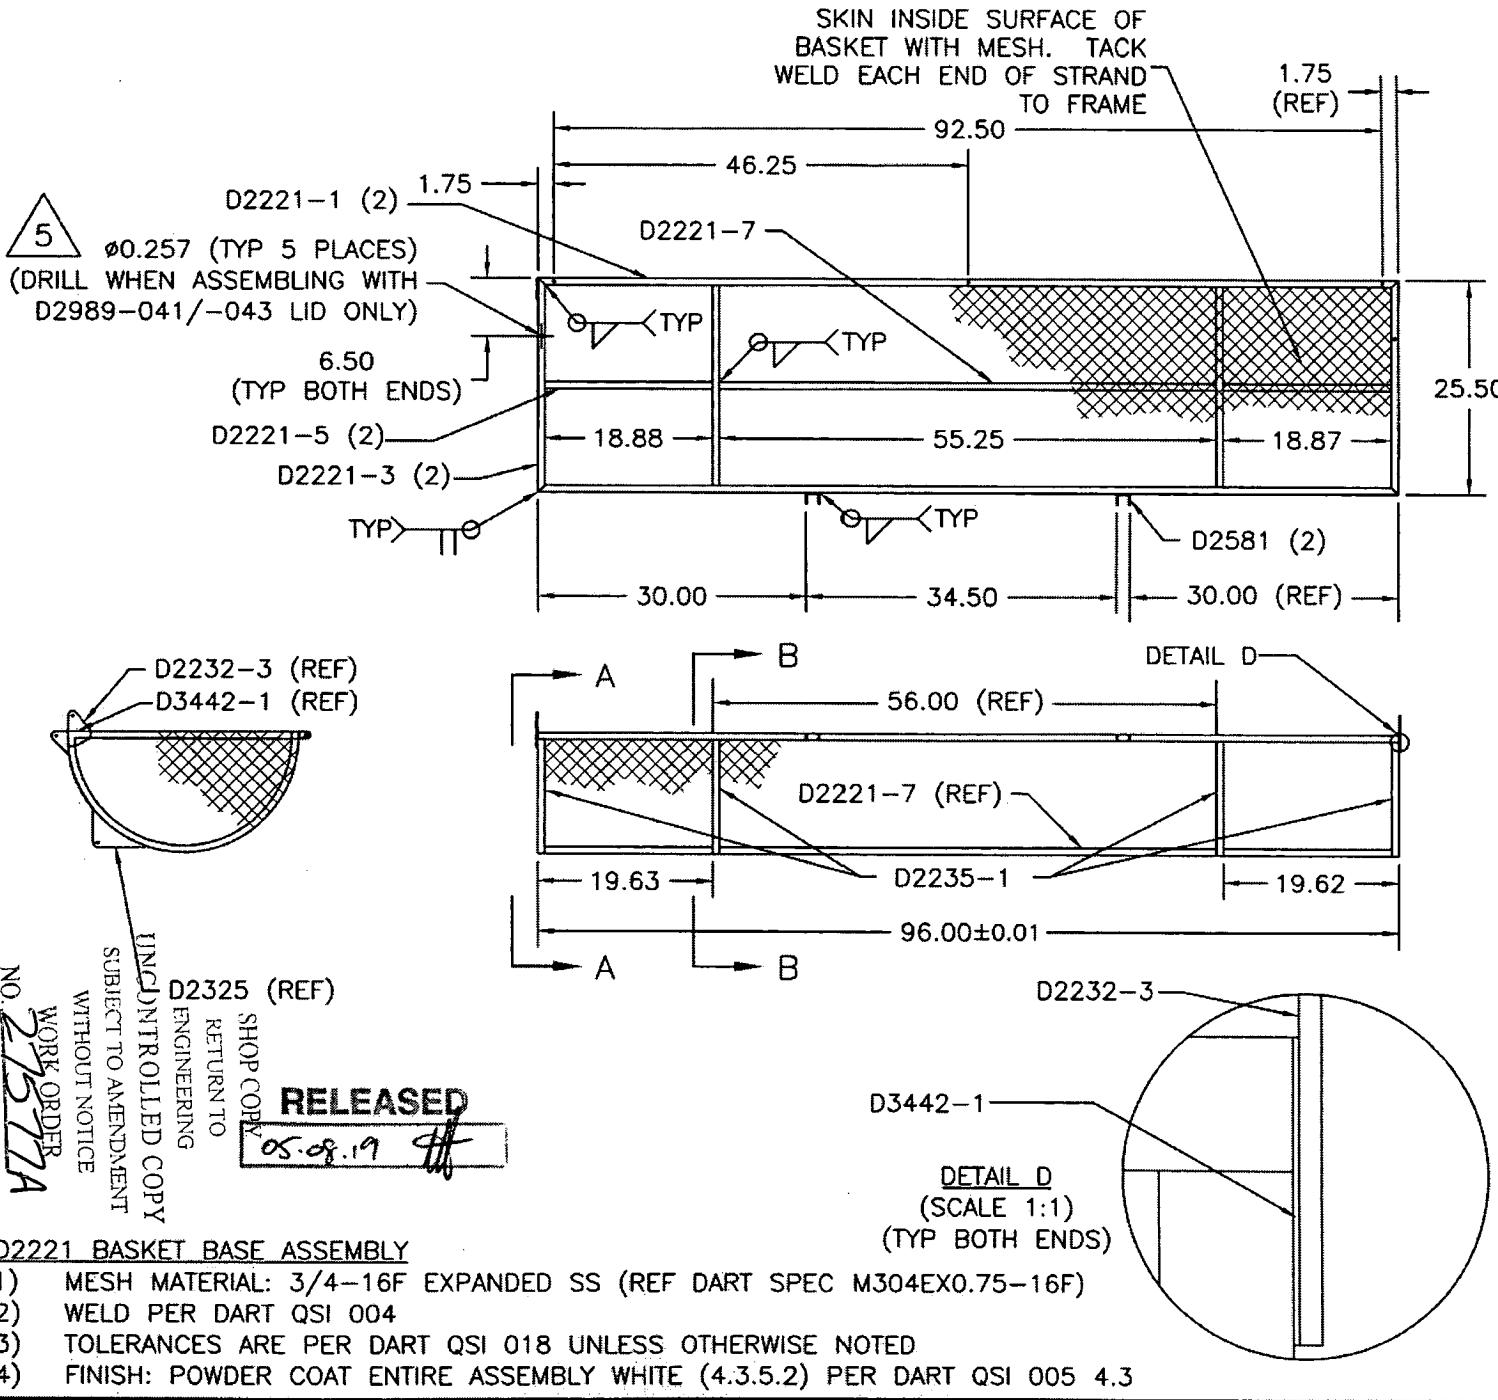
- 1) CUT LENGTH/SHAPE PER DIAGRAM AND PARTS LIST
- 2) MATERIAL: AISI 304/316 SS, 3/4 X 3/4 X 0.060 WALL SQUARE TUBING (REF. DART SPEC M304TS0.750W.060)
- 3) TOLERANCES ARE PER DART QSI 018 UNLESS OTHERWISE NOTED
- 4) ALL DIMENSIONS ARE IN INCHES
- 5) DRILL Ø0.257 HOLES ONLY WHEN ASSEMBLING D2221 BASE WITH D2989-041/-043 BASKET LID

Copyright © 1994 by DART AEROSPACE LTD

THIS DOCUMENT IS PRIVATE AND CONFIDENTIAL AND IS SUPPLIED ON THE EXPRESS CONDITION THAT IT IS NOT TO BE USED FOR ANY PURPOSE OR COPIED OR COMMUNICATED TO ANY OTHER PERSON WITHOUT WRITTEN PERMISSION FROM DART AEROSPACE LTD.

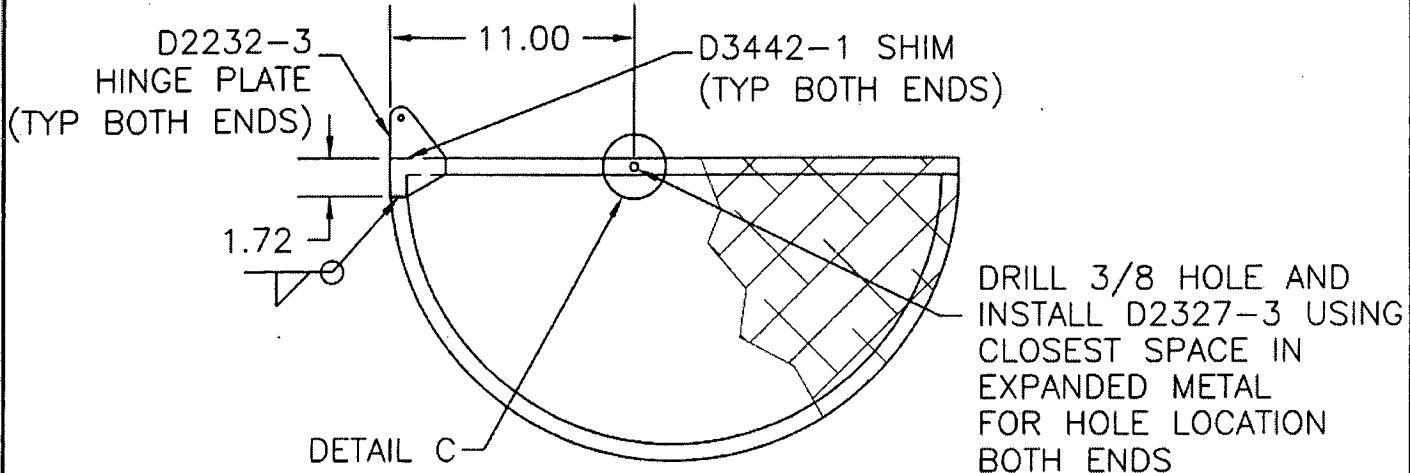
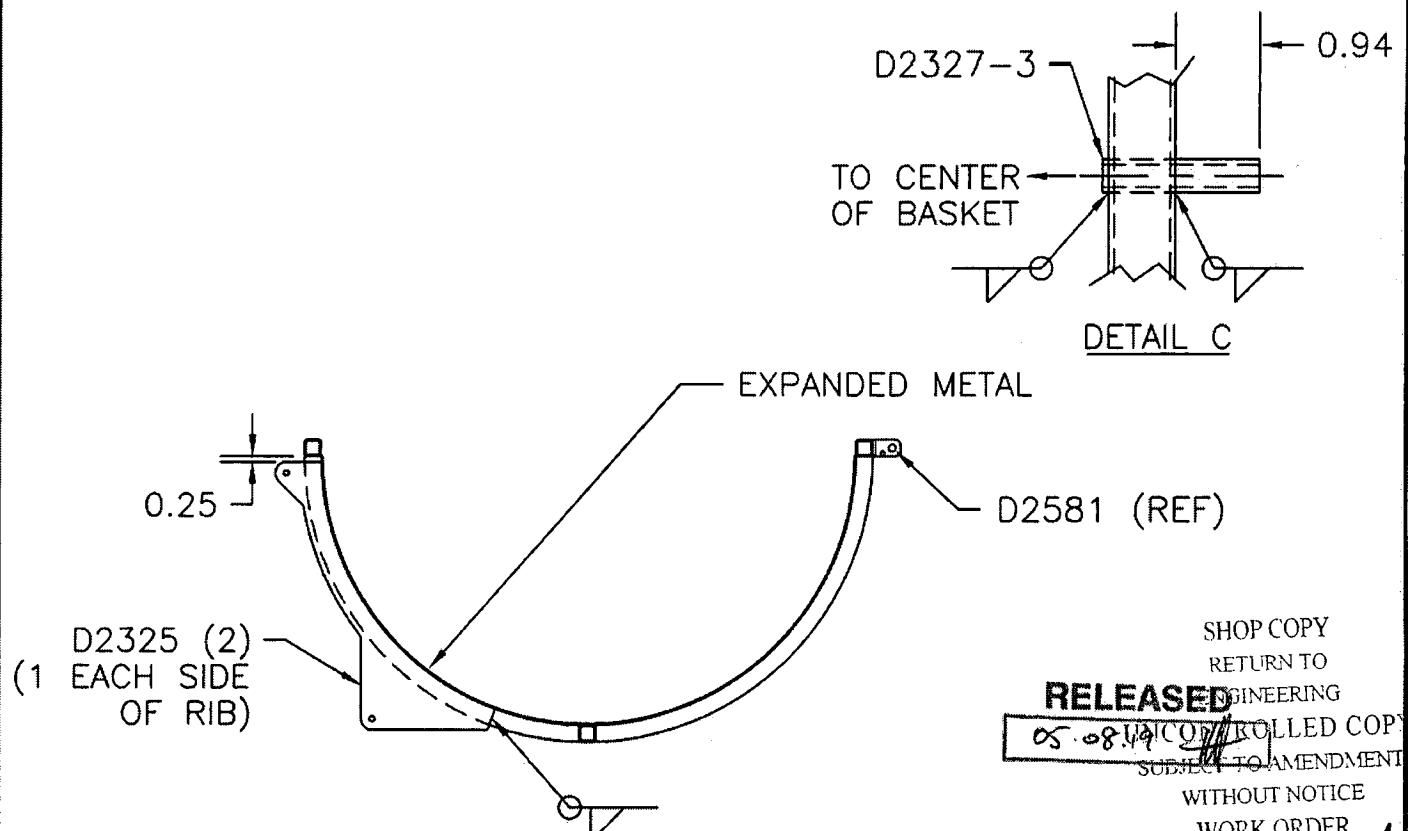
DART

DESIGN BW	DRAWN BY PH	DART AEROSPACE LTD HAWKESBURY, ONTARIO, CANADA
CHECKED <i>PH</i>	APPROVED <i>PH</i>	DRAWING NO. D2221
DATE 05.06.07	TITLE BASKET BASE ASSEMBLY (350)	REV. F SHEET 2 OF 3 SCALE 1:20



DART

DESIGN	BW	DRAWN BY	PH	DART AEROSPACE LTD
CHECKED		APPROVED		HAWKESBURY, ONTARIO, CANADA
				DRAWING NO. D2221 REV. F
DATE	05.06.07			SHEET 3 OF 3
				TITLE BASKET BASE ASSEMBLY (350) SCALE 1:8

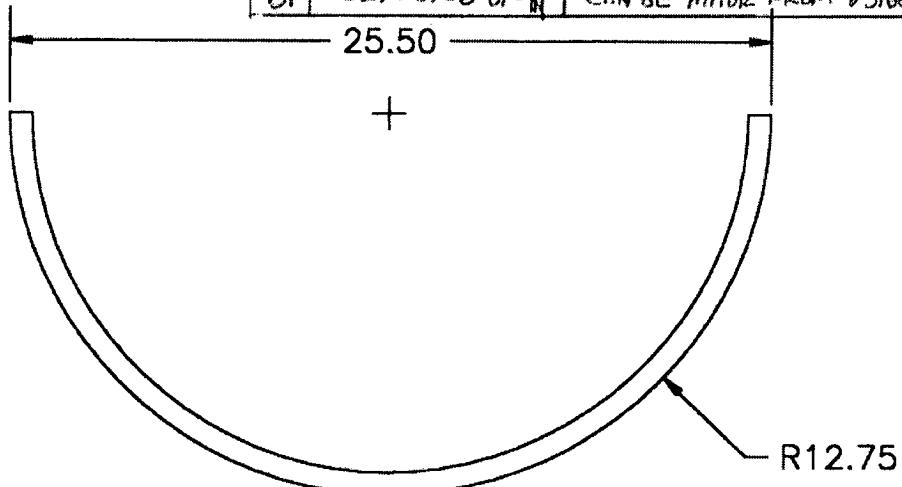
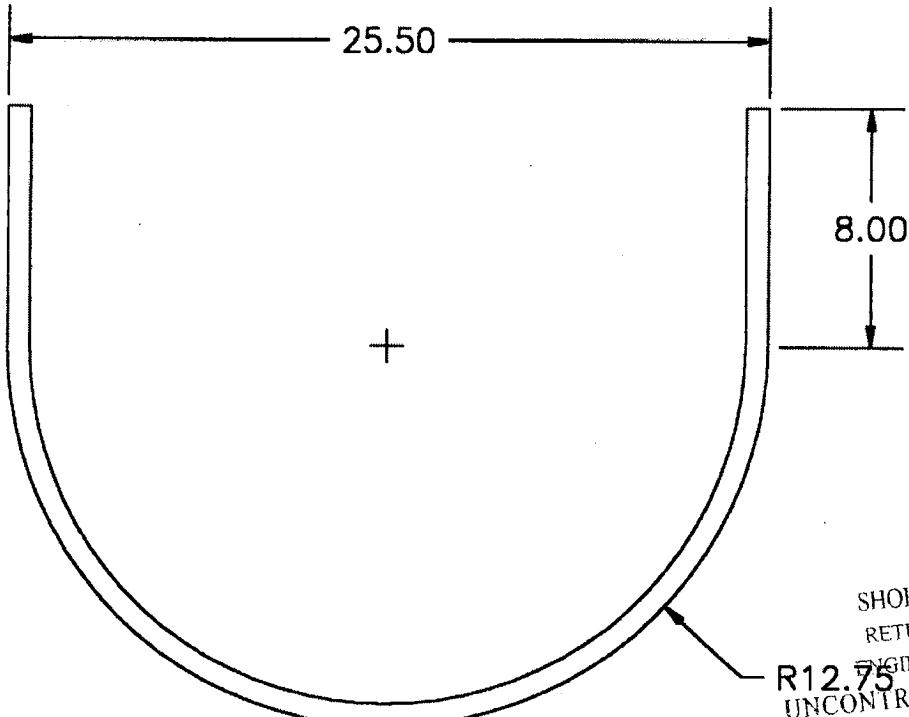
SECTION A-A SAME BOTH END RIBSSECTION B-B SAME BOTH CENTER RIBS

Copyright © 1994 by DART AEROSPACE LTD

THIS DOCUMENT IS PRIVATE AND CONFIDENTIAL AND IS SUPPLIED ON THE EXPRESS CONDITION THAT IT IS NOT TO BE USED FOR ANY PURPOSE OR COPIED OR COMMUNICATED TO ANY OTHER PERSON WITHOUT WRITTEN PERMISSION FROM DART AEROSPACE LTD.

DART

DESIGN B. WILLIAMS	DRAWN BY B. WILLIAMS	DART AEROSPACE LTD VICTORIA INTERNATIONAL AIRPORT, CANADA	
CHECKED <i>bw</i>	APPROVED <i>bw</i>	DRAWING NO. D2235	REV. B SHEET 1 OF 1
DATE 94:12:16		TITLE BASKET RIBS	SCALE

BI 02.08.06 ~~07~~ CAN BE MADE FROM D3166-1**RELEASED**
R960507D2235-1D2235-3

CAN BE MADE FROM D3166-1 BI
MATERIAL: 304/316 SS, 3/4 X 3/4 X 0.063 WALL SQR. NO. 27577A

SHOP COPY
RETURN TO
ENGINEERING
UNCONTROLLED COPY
SUBJECT TO AMENDMENT
WITHOUT NOTICE
WORK ORDER